


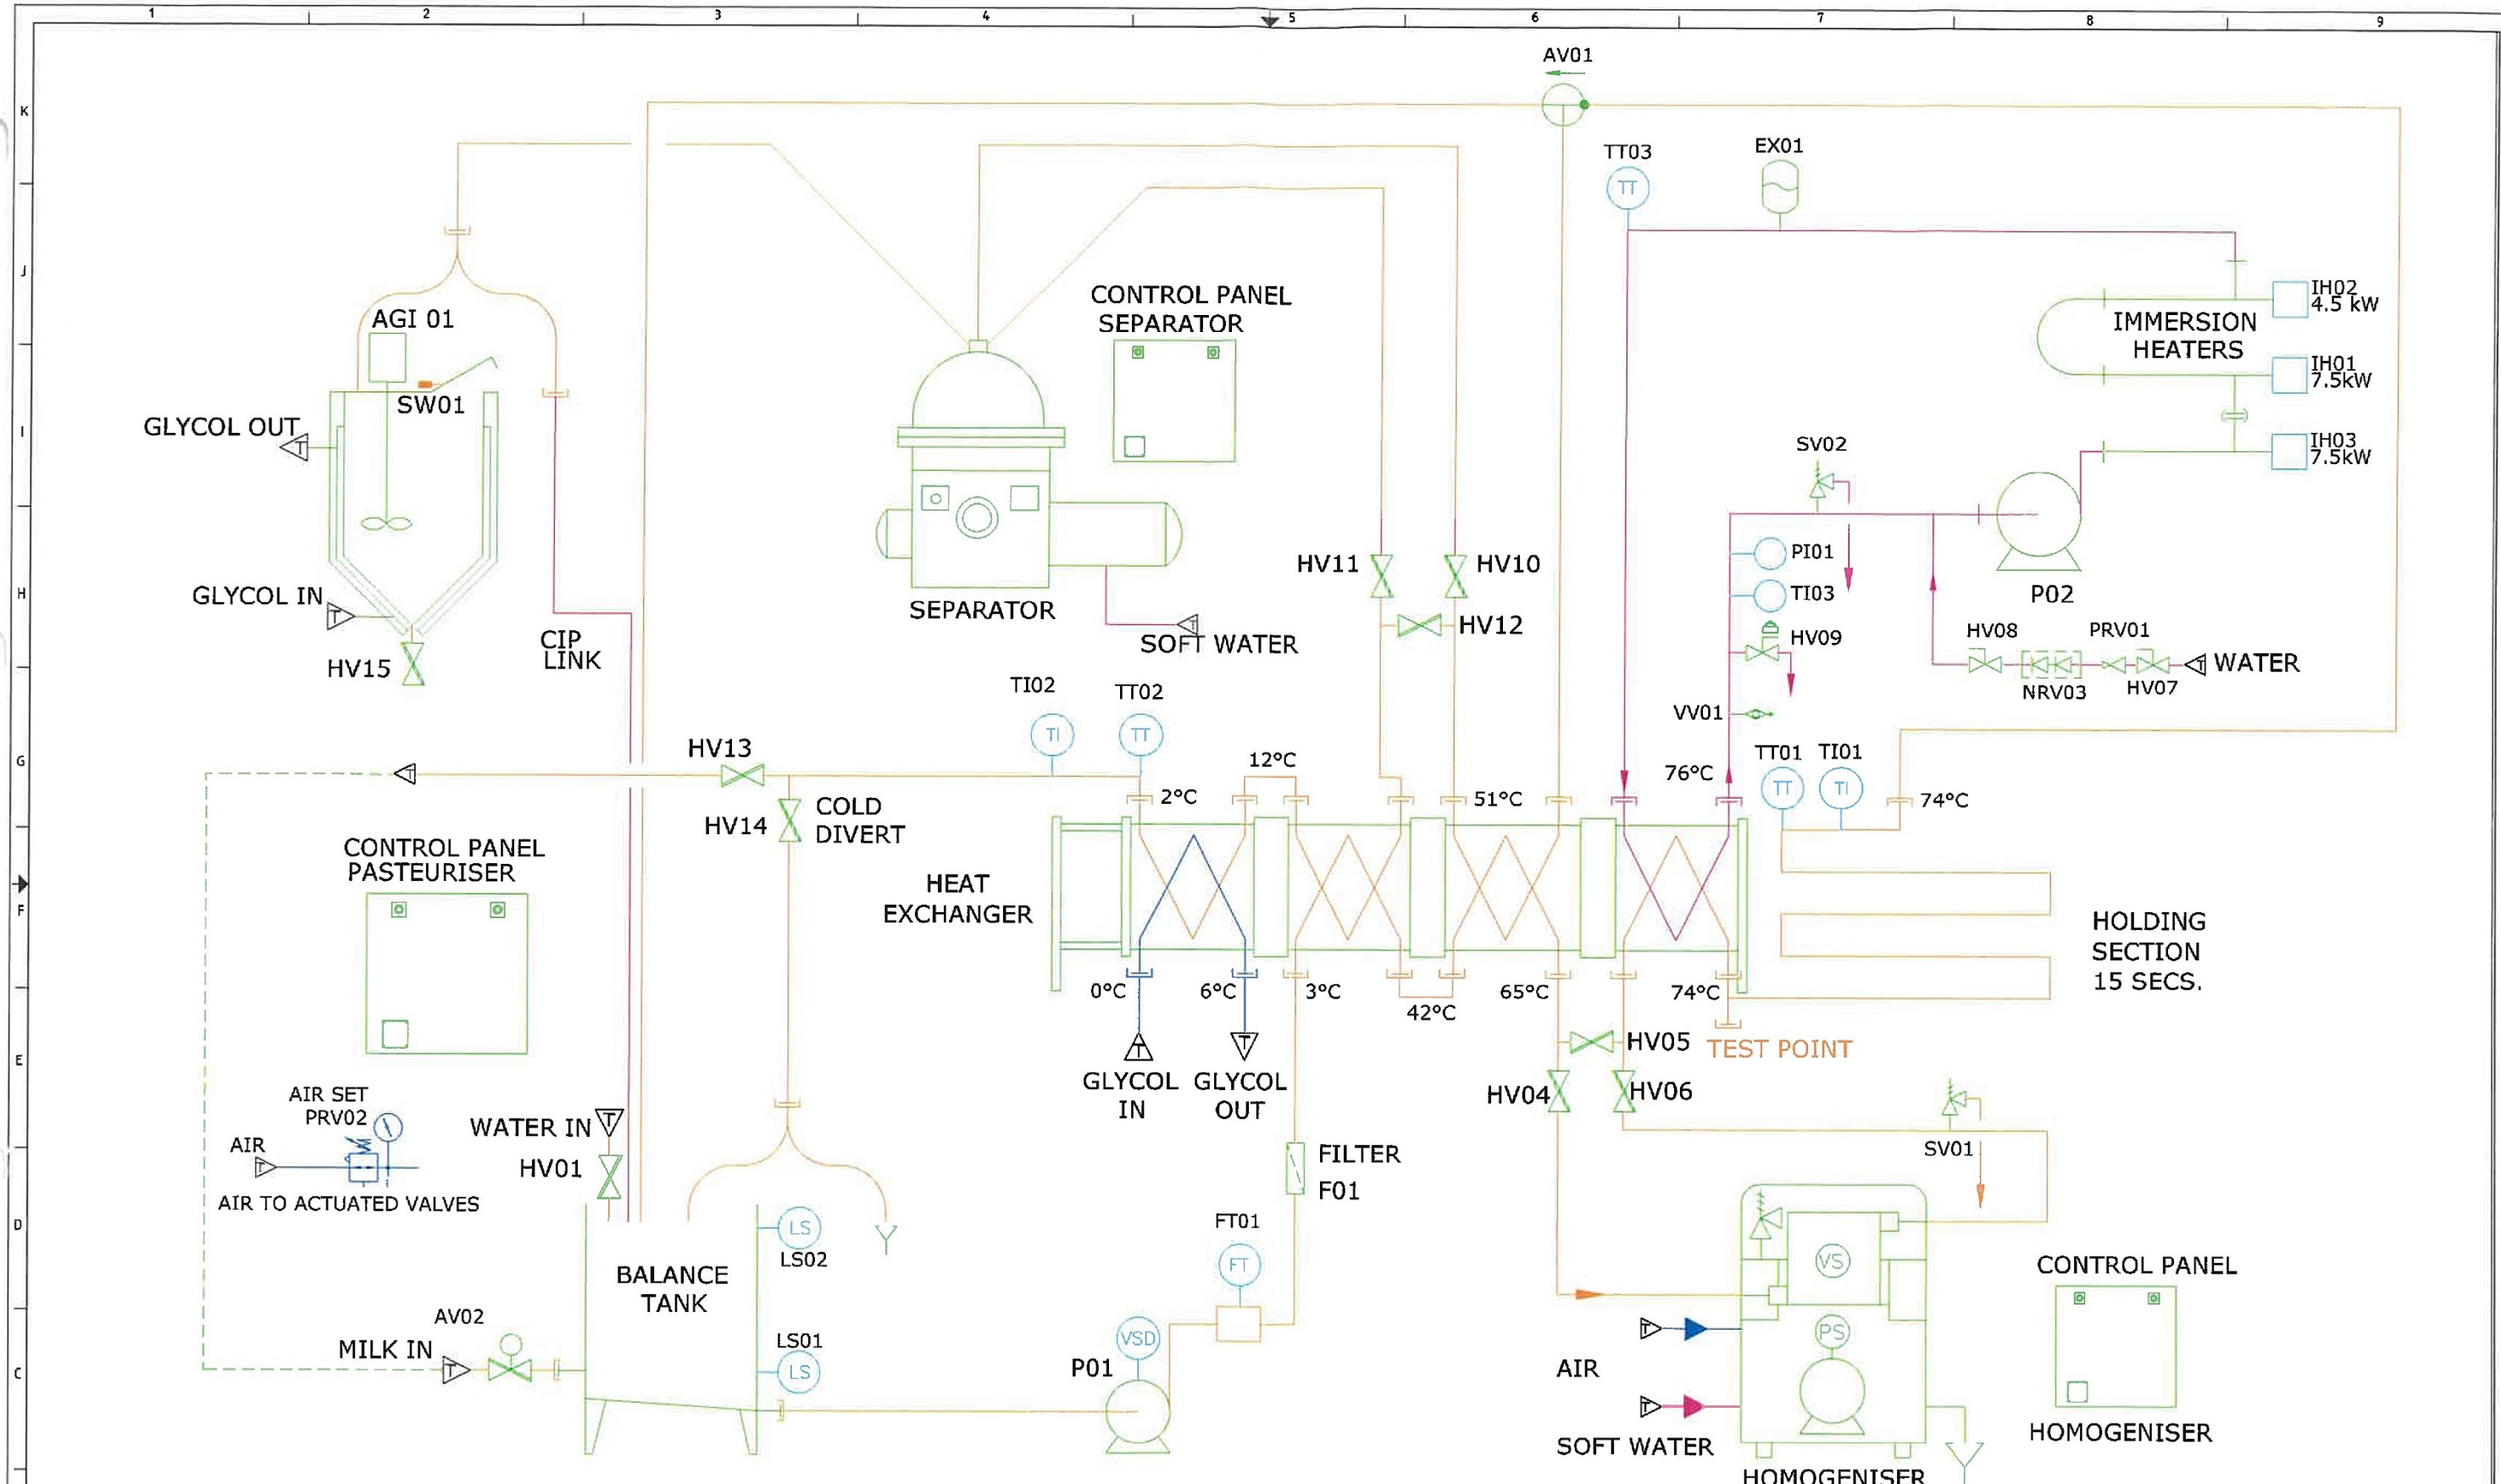

INSTRUMENTATION				LINE STYLES				FLOW SELECTOR PANEL				MISC. PIPELINE ITEMS				FILTERS/STRAINERS				TANK ANCL.				SELF ACTING VALVES				CONTROL VALVES				SAFETY BREAK VALVES				STOP/ROUTING VALVES				AUTOMATED VALVES				MANUAL VALVES				PUMPS			
C				HOT WATER SET UPDATED TO 'AS BUILT'				11/7/06				L.P.																																							
B				FLOWMETER ADDED FLOW VALVES REMOVED				12/5/06				G.O.																																							
A				MODIFIED FOLLOWING REVIEW				20/4/06				G.O.																																							
REV.				ALTERATION				DATE				SIG.																																							

Carlisle Process Systems Ltd
Coldharbour Business Park
Sherborne
Dorset DT9 4JW

Tel: +44 (0) 01935 818800
Fax: +44 (0) 01935 818818
enquires@carlisleuk.com
www.carlisleuk.com

CUSTOMER:-

TITLE:- **MILK PASTEURISER P & I.D.**

This drawing and its contents are Carlisle Process Systems Ltd. exclusive property and must not be copied, reproduced, transmitted or communicated to any other party, or used for purposes not expressly permitted by us.

DRAWN BY:- G.O.

DATE:- 12.4.06

SCALE:- N/A

No. OFF ONE

MACHINING SYMBOLS:-

FINISH:-

DWG. No:- DFB-4806-00

REV:- c